


This drawing is the copyright of Red 4 Limited. Reproduction, publication or any other usage of this drawing without permission of the company is against the law.
 Do not scale. The contractor shall verify all dimensions and existing conditions on site prior to commencing the works.
 This drawing should be read in conjunction with all other relevant documents.

Revisions :	Date :	By :
Revision A - Steel setting out added	15 Sept.'11	SP
Revision B - Column on A,3 omitted as per steel design scheme to prevent column A,4 being in front of glazing as requested by client.	19 Sept.'11	SP
Revision C - Adjusted to suit survey and bays 11-12 and 12-13 amended to move base away from boundary.	26 Sept.'11	SP
Revision D - Setting out information added	26 Sept.'11	SP
Revision E - Steels revised to co-ordinate with Templemill Engineering drawings.	25 Oct.'11	RT
Revision F - Fence and gate indicated to form secure compound.	20 Feb.'12	SP
Revision G - Lobby to stairs amended.	12 Mar.'12	SP
Revision H - Internal doors amended to suit site	28 Mar.'12	SP

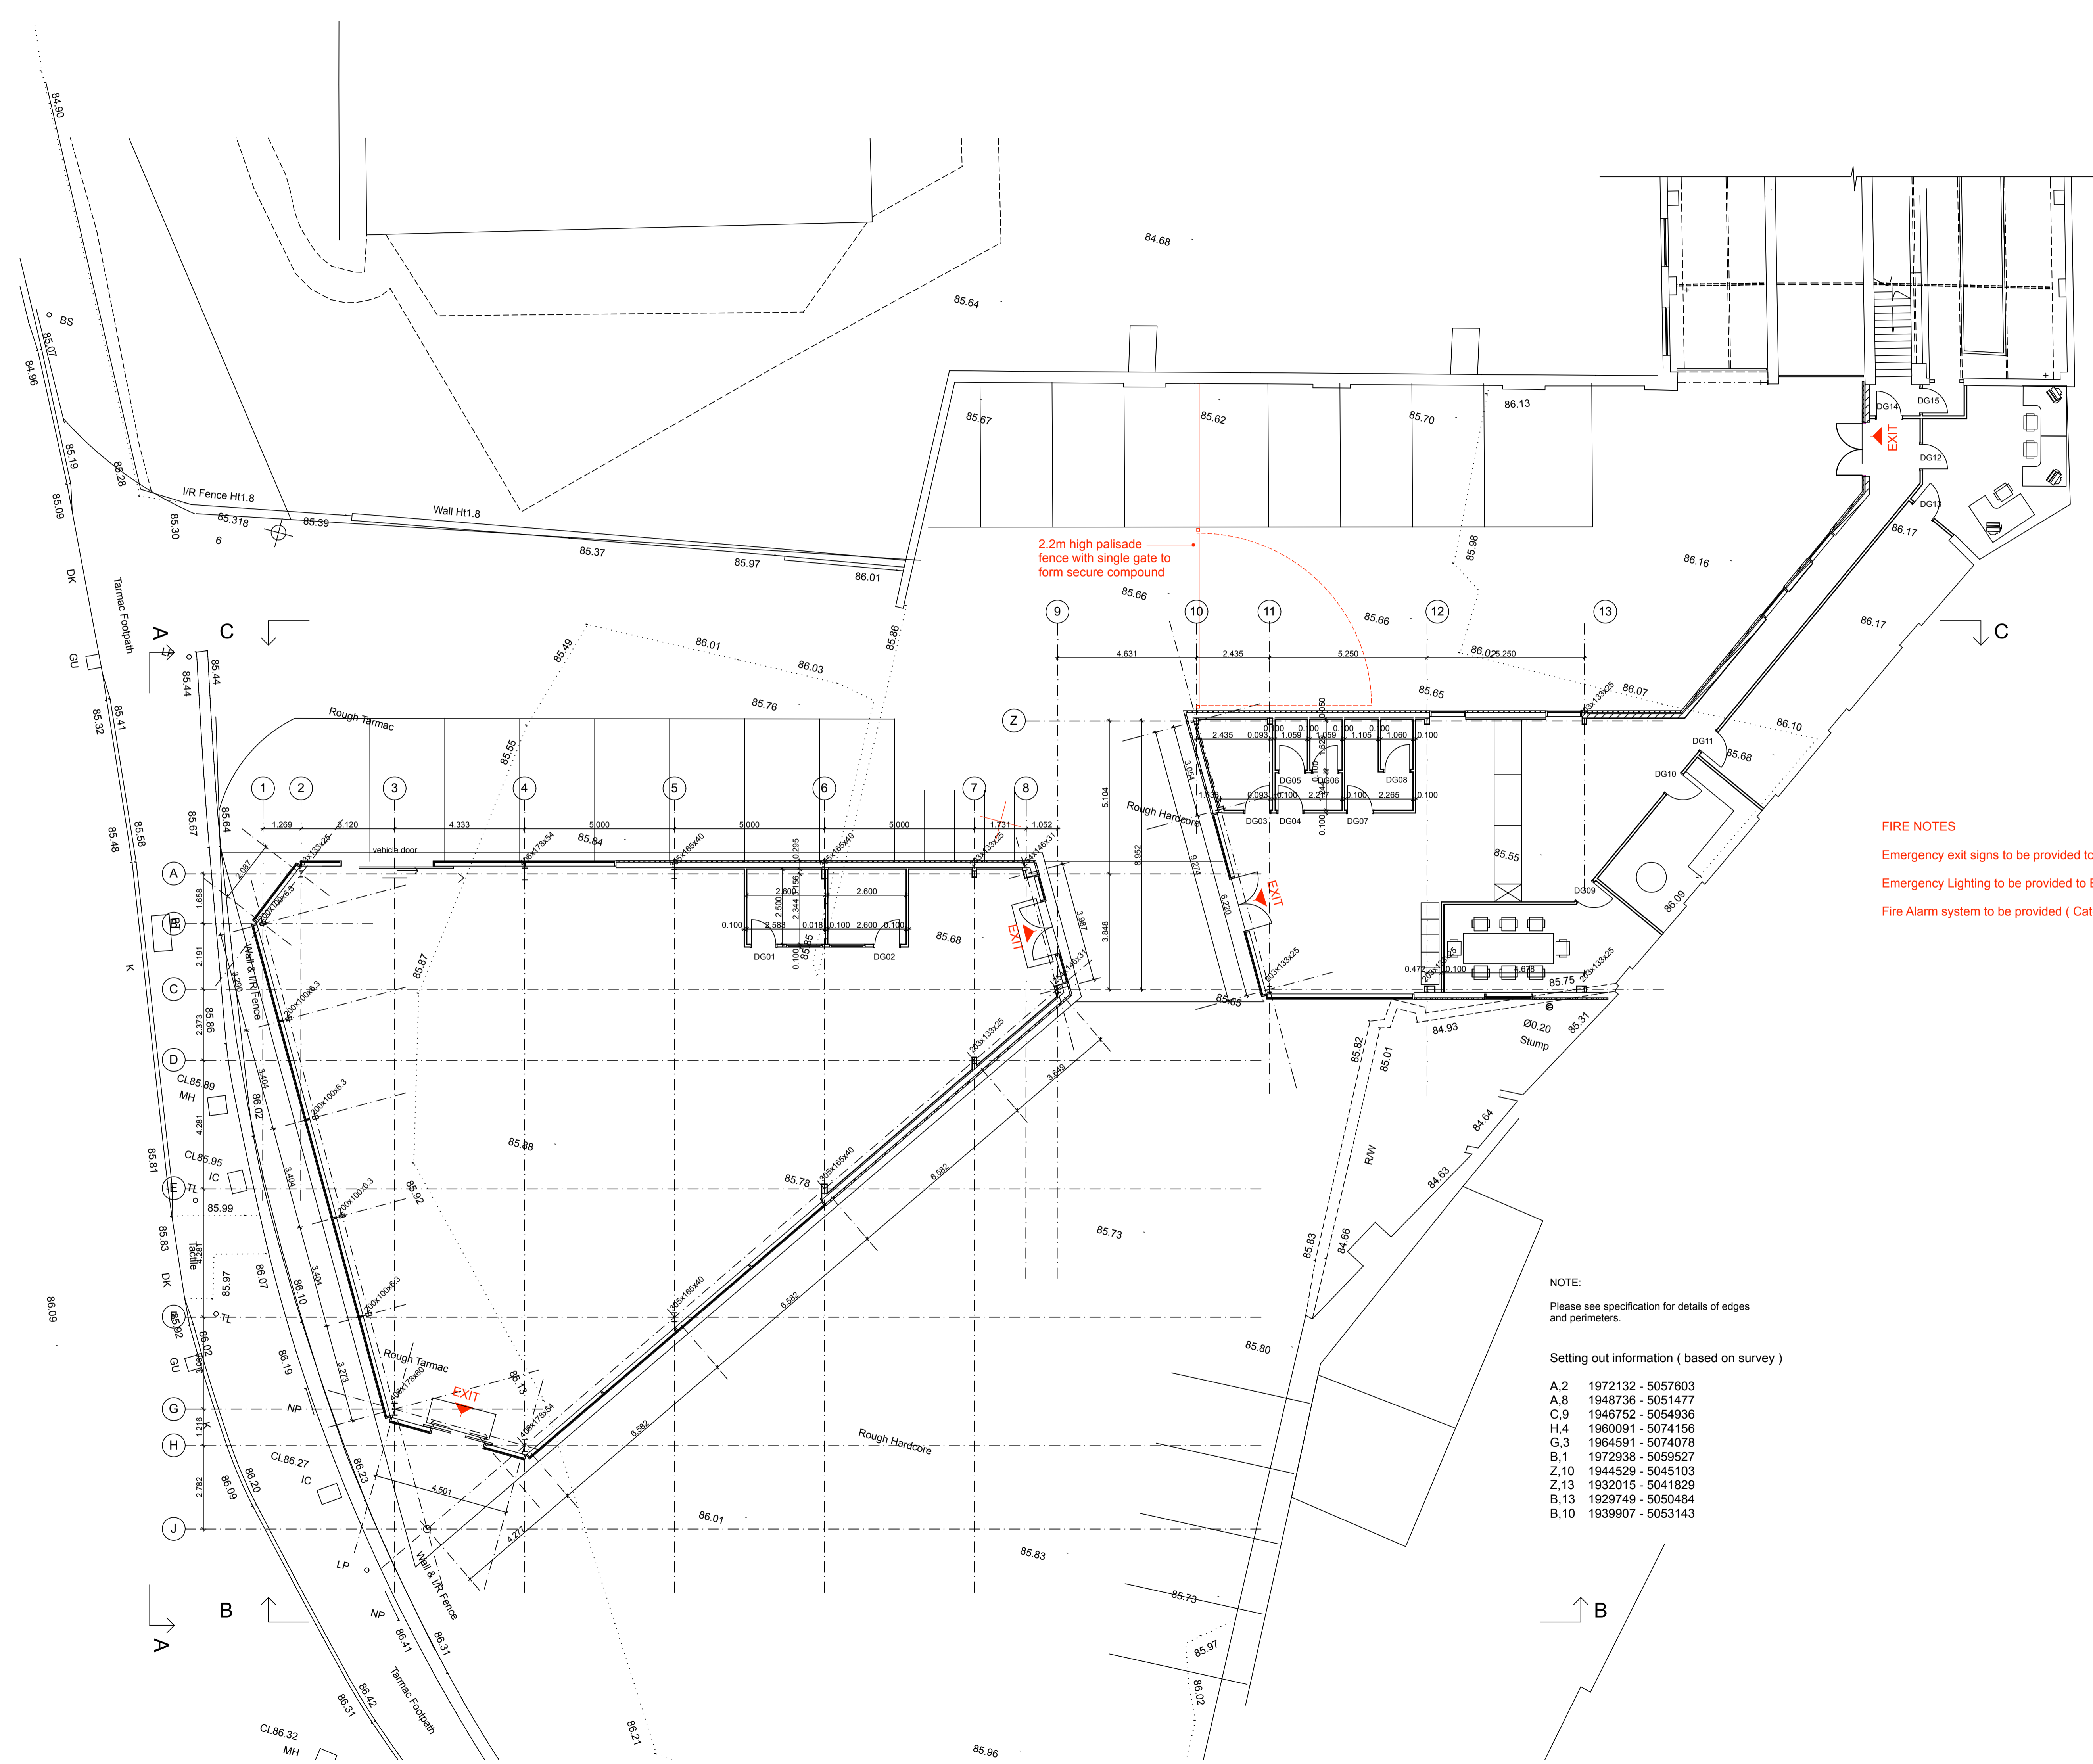

FIRE NOTES
 Emergency exit signs to be provided to BS 5499
 Emergency Lighting to be provided to BS 5266
 Fire Alarm system to be provided (Category 2).

NOTE:
 Please see specification for details of edges and perimeters.

Setting out information (based on survey)

A,2	1972132 - 5057603
A,8	1948736 - 5051477
C,9	1946752 - 5054936
H,4	1960091 - 5074156
G,3	1964591 - 5074078
B,1	1972938 - 5059527
Z,10	1944529 - 5045103
Z,13	1932015 - 5041829
B,13	1929749 - 5050484
B,10	1939907 - 5053143



red 4 architects

8 pride point drive
 pride park
 derby
 de24 8bx
 t: 01332 200089
 f: 01332 200054
 e: enquiries@red4architects.co.uk
 w: www.red4architects.co.uk
 Project

Proposed New Car Showroom for Sandcliffe
 London Road, Leicester.

Drawing
 Ground Floor plan as Proposed
 Scale : Date : Drawn by : Checked by :

1 : 100 Sept.'11 SP
 Job number : Drawing number : Revision:
 L 622 PO1 H